

Test Report

for

KETE Window Wall System 150D

for AS/NZS 4284:2008

(SLS pressure =+/-2.50 kPa)

(ULS pressure =+/-4.70 kPa)



KETE Window Wall System 150D

RESEARCH ENGINEERING DEVELOPMENT
FACADE CONSULTANTS LIMITED

25 NOVEMBER 2019

Report GR19A04-1A

Table of Content

Section	Description	Page
1.	Introduction	3
2.	Witness on the Test	4
3.	Test Information	4
4.	Details of the Test Specimen	5
5.	Test Specification and Sequence	6
6.	Test Procedure and Observations	12
6.1.1	Preliminary Test- Static Pressure Test	12
6.1.2	Preliminary Test- Water Penetration Test -Static	12
6.1.3	Preliminary Test- Water Penetration Test -Cyclic	12
6.2	Structural Test at Serviceability Limit State	13
6.3	Operating Force Test	17
6.4	Air Infiltration Test	17
6.5	Water Penetration Test - Static	18
6.6	Water Penetration Test - Cyclic	18
6.7	Proof Test at Ultimate Limit State	18
7.	Summary of Test Results	19
	Appendices	20
	Figure 1 - Location of displacement transducers	21
	Photographs of the PMU Test mock-up	22
	As-built PMU Test drawings from client	23

1. Introduction

This report describes the test conducted for the **KETE Window Wall System 150D** designed by **Guangdong Kete Facadetech Co., Ltd.** The test has been conducted by using the actual samples and simulated conditions in a test chamber against the following specifications in order to ensure the safety and serviceability of the system.

- 1-1.1 Preliminary Test-Static Pressure Test (AS/NZS 4284:2008 Clause 8.2.2)
- 1-1.2 Preliminary Test-Water Penetration Test - Static (AS/NZS 4284:2008 Clause 8.2.3)
- 1-1.3 Preliminary Test-Water Penetration Test - Cyclic (AS/NZS 4284:2008 Clause 8.2.3)
- 1-2 Structural Test at Serviceability Limit State (AS/NZS 4284:2008 Clause 8.3)
- 1-3 Operating Force Test (AS/NZS 4420.1-2016 Section 4)
- 1-4 Air Infiltration Test (AS/NZS 4284:2008 Clause 8.4)
- 1-5 Water Penetration Test - Static (AS/NZS 4284:2008 Clause 8.5)
- 1-6 Water Penetration Test - Cyclic (AS/NZS 4284:2008 Clause 8.6)
- 1-7 Proof Test at Ultimate Limit State (AS/NZS 4284:2008 Clause 8.8)

2. Witness on the Test

Mr. John Zhuo and
Mr. Kim Dong of

Guangdong Kete Facadetech Co., Ltd.

3. Test Information

Location of Testing Laboratory: No.111, Jiaoxin Road, Lanhe Town, Nansha District,
Guangzhou, China

Test Engineer

Dr. Joe Cheung of
**Research Engineering Development
Facade Consultants Limited (HOKLAS No. 91)**

System Designers:

Guangdong Kete Facadetech Co., Ltd.

Date of Test:

22nd January 2019

4. Details of the Test Specimen

4.1 General Description

The specimen is constructed in accordance with the actual size section using the identical material to the material designed by **Guangdong Kete Facadeteck Co., Ltd.** and to be used in the future projects. The construction method and fixing of the specimen is also the same as the method used in actual installation of the systems on future project sites.

4.2 Testing Sample

KETE Window Wall System 150D is a window wall system including an awning window and a fixed panel. The dimension of the specimen: 3.02 m width x 2.70 m height.

4.3 As-built PMU Testing Drawing (Enclosed)

M-01-0, M-02-0, M-03-0, M-04-0, DY-101A-0, JD-01-0, JD-02-0, JD-03-0, JD-04-0, JD-05-0, JD-06-0, JD-07-0, JD-08-0, JD-09-0, JD-10-0

4.4 Glass

8mm Tempered (Heat soaked) + 12A + 8mm Tempered (Heat soaked)

4.5 Sealant

GUIBAO 998 for weather sealant

4.6 Equipment

The externally mounted chamber is equipped with a manometer, air and water flowmeter, water pump and air-blowers. The deformation of specimen shall be detected by electronic transducers.

5. Test Specification and Sequence

5.1.1 Preliminary Test-Static Pressure Test (AS/NZS 4284:2008 Clause 8.2.2)

Procedure

Preload the specimen to +2.5/-2.5kPa (positive and negative SLS design wind pressure) for 10 seconds respectively.

Requirement

No separation, plastic deformations or deleterious should be observed.

5.1.2 Preliminary Test-Water Penetration Test - Static (AS/NZS 4284:2008 Clause 8.2.3)

Procedure

- (a) The test façade shall be subjected to water sprayed completely and continuously over the exterior face of the test sample at a rate not less than 0.05L/ m². sec.
- (b) At the start of the test, the water spray operates for 5 minutes with zero pressure.
- (c) Apply the air pressure difference of **1000 Pa** promptly and maintain a pressure along with the specified rate of water spray for 15 minutes.
- (d) Remove the air pressure difference and stop the water spray.
- (e) Observation of the internal surface of the specimen shall be carried out during the water spray operation and for 5 minutes after the water spray has stopped and there is zero pressure differential on the specimen.
- (f) Any water appearing on the inside surfaces of the façade shall be recorded, with the extent and, if possible, the source of leakage indicated.

Requirement

No water leakage should be observed.

5.1.3 Preliminary Test-Water Penetration Test - Cyclic (AS/NZS 4284:2008 Clause 8.2.3)

Procedure

- (a) The test shall be performed upon completion of the static water test. Should the cyclic water test not commence within 30 min of the static water test then before the start of the test, the water spray operates for 5 minutes with zero pressure.
- (b) Adjust the water spray to the specified rate not less than 0.05L/ m². sec.
- (c) Apply a cyclic positive air pressure for a duration of 5.0 minutes. The applied pressure shall be varied between the specified limits with a cycle time of 3 s to 5 s.
- (d) Record the cyclic pressure by the pressure gauge data logger.

<u>Pressure</u>	<u>Duration</u>
450 - 900 - 450 Pa	5 min.
0.00 Pa	2 min.
600 - 1200 - 600 Pa	5 min.
0.00 Pa	2 min.
900 - 1800 - 900 Pa	5 min.

- (e) Remove the air pressure difference and stop the water spray.
- (f) Observation of the internal surface of the specimen shall be carried out during the water spray operation and for 5 minutes after the water spray has stopped and there is zero pressure differential on the specimen.

Requirement

No water leakage should be observed.

5.2 Structural Test at Serviceability Limit State (AS/NZS 4284:2008 Clause 8.3) Procedure

Positive / negative pressure up to 100% of the SLS Wind Pressure is applied as follows:

Take-up

<u>Pressure (kPa)</u>	<u>Duration</u>	<u>Observation</u>
2.5 (100%)	2 min.	take readings (Initial take-up period)
0.0	2 min.	take readings then set zero (Zero stage Z1)

Mode 1


<u>Pressure (kPa)</u>	<u>Duration</u>	<u>Observation</u>
0.5 (20%)	1 min.	take readings
1.0 (40%)	1 min.	take readings
1.5 (60%)	1 min.	take readings
2.0 (80%)	1 min.	take readings
2.5 (100%)	1 min.	take readings
0.0	2 min.	take readings (Zero stage Z2)
2.5 (100%)	1 min.	take readings
2.0 (80%)	1 min.	take readings
1.5 (60%)	1 min.	take readings
1.0 (40%)	1 min.	take readings
0.5 (20%)	1 min.	take readings
0.0	2 min.	take readings (Zero stage Z3)

Mode 2

<u>Pressure (kPa)</u>	<u>Duration</u>	<u>Observation</u>
-2.5 (100%)	2 min.	take readings (take-up period)
0.0	2 min.	take readings (Zero Stage Z4)
-0.5 (20%)	1 min.	take readings
-1.0 (40%)	1 min.	take readings
-1.5 (60%)	1 min.	take readings
-2.0 (80%)	1 min.	take readings
-2.5(100%)	1 min.	take readings
0.0	2 min.	take readings (Zero stage Z5)
-2.5 (100%)	1 min.	take readings
-2.0 (80%)	1 min.	take readings
-1.5 (60%)	1 min.	take readings
-1.0 (40%)	1 min.	take readings
-0.5 (20%)	1 min.	take readings
0.0	2 min.	take readings (Zero stage Z6)

Mode 3

<u>Pressure (kPa)</u>	<u>Duration</u>	<u>Observation</u>
2.5 (100%)	2 min.	take readings
0.0	2 min.	take readings (Zero stage Z7)

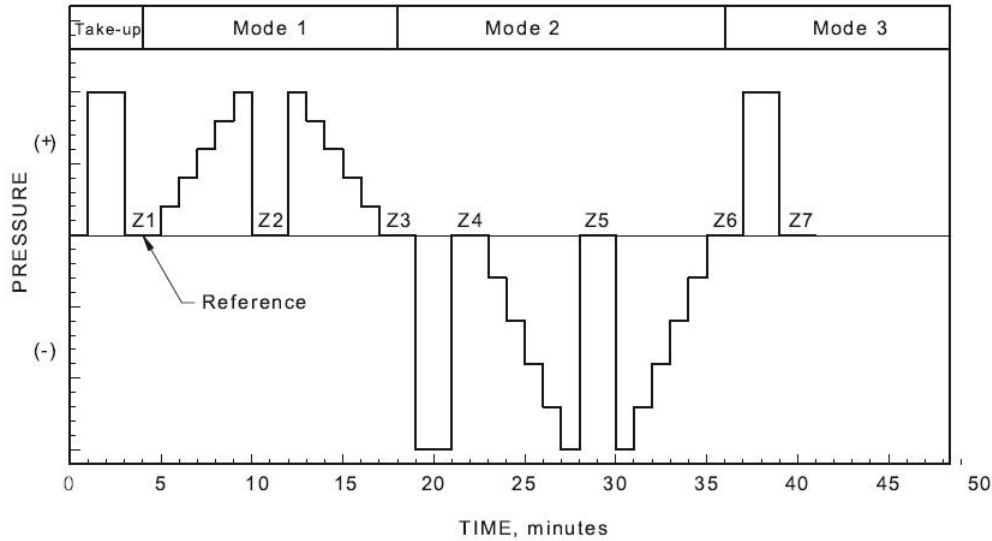

NOTE: The displacements used for deflection/span ratios are based on zero deflections at the reference stages Z1 and Z4. The reducing pressure steps from Z2 to Z3 and from Z5 to Z6 are optional.

Requirement

The performance of the specimen is evaluated against the following criteria.

- (i) The glass should not break.
- (ii) The deflection of the framing members of the specimen should not exceed span/250, during the positive and negative pressure tests.
- (iii) The glass panel deflection should not exceed span/60.
- (iv) Maximum successive member displacement should not exceed 3mm.
- (v) Maximum displacement (Framing member) should not exceed 20 mm.

5.3 Operating Force Test (AS/NZS 4420.1-2016 Clause 4)**Procedure**

Measure the starting force and operating force required to move the operable panel with a load cell system. The measurement shall be carried out three times and the mean of each set of three readings shall be taken.

Requirement (AS2047-2014 Table 2.2)

Product and movement type	Initiate (N)	Maintain (N)
Projecting Sash	160	80

5.4 Air Infiltration Test (AS/NZS 4284:2008 Clause 8.4)**Procedure**

- (a) Adjust the air flow through the test chamber to provide the specified test pressure difference across the test specimen. The total air infiltration rates through the specimen and the test chamber shall be measured by positive and negative pressure. No further testing shall be required if the air infiltration rates determined on combined specimen and test chamber are less than the specified air infiltration rate.
- (b) Where the total air infiltration rate is greater than the specified air infiltration rates, or the specifier requires actual air infiltration rates, the face of the specimen shall be sealed airtight by covering it with an impervious film. If this is not practicable, all joints, weepholes and glazing or sealant lines of the specimen shall be sealed with air-impervious tape and air infiltration rates of the chamber only determined. The air infiltration rates through the specimen shall be the difference between the total and sealed airflow meter readings at both positive and negative pressures.

Air infiltration is to be checked under pressure of +/-150 Pa and +/-300 Pa.

Requirement

Air infiltration rate should not exceed: 1.6 L/sec/m²

5.5 Water Penetration Test - Static (AS/NZS 4284:2008 Clause 8.5)

Procedure

- (a) The test façade shall be subjected to water sprayed completely and continuously over the exterior face of the test sample at a rate not less than 0.05L/ m². sec.
- (b) At the start of the test, the water spray operates for 5 minutes with zero pressure.
- (c) Apply the air pressure difference of **1000 Pa** promptly and maintain a pressure along with the specified rate of water spray for 15 minutes.
- (d) Remove the air pressure difference and stop the water spray.
- (e) Observation of the internal surface of the specimen shall be carried out during the water spray operation and for 5 minutes after the water spray has stopped and there is zero pressure differential on the specimen.
- (f) Any water appearing on the inside surfaces of the façade shall be recorded, with the extent and, if possible, the source of leakage indicated.

Requirement

No water leakage should be observed.

5.6 Water Penetration Test - Cyclic (AS/NZS 4284:2008 Clause 8.6)

Procedure

- (a) The test shall be performed upon completion of the static water test. Should the cyclic water test not commence within 30 min of the static water test then before the start of the test, the water spray operates for 5 minutes with zero pressure.
- (b) Adjust the water spray to the specified rate not less than 0.05L/ m². sec.
- (c) Apply a cyclic positive air pressure for a duration of 5.0 minutes. The applied pressure shall be varied between the specified limits with a cycle time of 3 s to 5 s.
- (d) Record the cyclic pressure by the pressure gauge data logger.

<u>Pressure</u>	<u>Duration</u>
450 - 900 - 450 Pa	5 min.
0.00 Pa	2 min.
600 - 1200 - 600 Pa	5 min.
0.00 Pa	2 min.
900 - 1800 - 900 Pa	5 min.
- (e) Remove the air pressure difference and stop the water spray.
- (f) Observation of the internal surface of the specimen shall be carried out during the water spray operation and for 5 minutes after the water spray has stopped and there is zero pressure differential on the specimen.

Requirement

No water leakage should be observed.

5.7 Structural Test at Ultimate Limit State (AS/NZS 4284:2008 Clause 8.8)**Procedure**

Positive / negative pressure up to Ultimate Limit State is applied and held for 10 seconds.

Positive**Pressure**

0 to 4.7 kPa

4.7 kPa

Duration

50s-60s

10s

Negative**Pressure**

0 to -4.7 kPa

-4.7 kPa

Duration

50s-60s

10s

The sample shall be inspected at the end of each of the positive and negative pressure stages. Record all incidences of non-linear deflection and/or collapse.

Requirement

There shall be no collapse of the test sample. Collapse shall mean any one or any combination of the following:

- (a) Disengagement or partial disengagement of any framing member, façade panel or any part thereof.
- (b) Failure of any fixings that connect the façade to the building structure, such that the test sample is unstable.
- (c) Failure of any stop, locking device, fastener or support which would allow an opening light to come open.
- (d) Repeated breakage of glass resulting in loss of chamber pressure. Glass may only be replaced once before the sample is deemed to have collapsed.
- (e) Repeated cracking of glass which does not result in loss of chamber pressure. Glass may only be replaced twice before the sample is deemed to have collapsed.
- (f) Any permanent distortion of a panel shall be noted and documented in the test

6. Test Procedure and Observations

6.1.1 Preliminary Test-Static Pressure Test (AS/NZS 4284:2008 Clause 8.2.2) Procedure

The testing procedures described in section 5.1.1 were followed.

Observation

No separation, plastic deformations or deleterious was observed.

6.1.2 Preliminary Test-Water Penetration Test - Static (AS/NZS 4284:2008 Clause 8.2.3) Procedure

The testing procedures described in section 5.1.2 were followed.

Observation

No water leakage was observed.

6.1.3 Preliminary Test-Water Penetration Test - Cyclic (AS/NZS 4284:2008 Clause 8.2.3) Procedure

The testing procedures described in section 5.1.3 were followed.

Observation

No water leakage was observed.

6.2 Structural Test at Serviceability Limit State (AS/NZS 4284 Clause 8.3) Procedure

The testing procedures described in section 5.2 were followed.

Observation for positive pressure up to 2.50 kPa

(For Locations of transducers, please refer to Figure 1)

Pressure in kPa	Displacement in mm								
	Locations of Transducers								
	Mullion Span = 2560 mm			Mullion Span = 1365 mm			Transom Span = 1365 mm		
	1	2	3	4	5	6	7	8	9
Take-up									
At Pressure = 2.50	4.78	13.82	6.71	8.79	13.57	14.84	3.73	9.29	13.29
At Pressure = 0.00	0.48	0.59	0.36	0.67	0.85	0.92	0.29	0.48	0.64
<i>Zero reference</i>	0.00	0.00	0.00	0.00	0.00	0.00	0.00	0.00	0.00
Mode 1									
At Pressure = 0.50	0.56	2.60	1.61	2.00	2.62	2.61	0.51	1.50	2.38
At Pressure = 1.00	1.78	5.85	3.67	4.61	5.89	5.96	1.19	3.46	5.41
At Pressure = 1.50	2.86	8.56	4.82	6.12	8.41	8.90	1.87	5.32	8.05
At Pressure = 2.00	3.65	11.00	5.66	7.22	10.59	11.54	2.66	7.07	10.44
At Pressure = 2.50	4.34	13.30	6.39	8.19	12.75	14.03	3.52	8.88	12.73
Relative Disp. (mm)	--	7.935	--	--	1.640	--	--	0.755	--
Permitted Relative Displ. #	--	10.240	--	--	5.460	--	--	5.460	--
At Pressure = 0.00	0.05	0.07	0.09	0.10	0.10	0.10	0.05	0.05	0.07
Relative Disp. (mm)	--	0.000	--	--	0.000	--	--	-0.010	--
At Pressure = 2.50	4.33	13.26	6.32	8.08	12.61	13.96	3.49	8.86	12.69
Relative Disp. (mm)	--	7.935	--	--	1.590	--	--	0.770	--
Permitted Relative Displ. #	--	10.240	--	--	5.460	--	--	5.460	--
At Pressure = 2.00	4.04	11.46	5.87	7.47	11.15	12.16	3.00	7.64	10.97
At Pressure = 1.50	3.57	9.38	5.19	6.55	9.26	9.98	2.33	6.13	8.94
At Pressure = 1.00	2.98	7.21	4.41	5.51	7.26	7.64	1.62	4.57	6.85
At Pressure = 0.50	1.98	4.08	2.60	3.27	4.13	4.26	0.81	2.52	3.88
At Pressure = 0.00	0.07	0.08	0.10	0.12	0.12	0.12	0.04	0.06	0.08
Relative Disp. (mm)	--	-0.005	--	--	0.000	--	--	0.000	--

note -The Deflection of Framing Member should not exceed span/250

Detailed Calculation for Relative Deflections at Design Wind Load (2.50 kPa)

Relative Deflection of Mullion at Locations 1, 2 and 3

$$= 13.30 - (4.34 + 6.39)/2$$

$$= 7.935 \text{ mm} < \text{Span} / 250 = 2560.0 / 250 = 10.240 \text{ mm}$$

$$= \text{span} / 323 = 10.240 \text{ mm} \quad \text{O.K.}$$

Relative Deflection of Mullion at Locations 4, 5 and 6

$$= 12.75 - (8.19 + 14.03)/2$$

$$= 1.640 \text{ mm} < \text{Span} / 250 = 1365.0 / 250 = 5.460 \text{ mm}$$

$$= \text{span} / 832 = 5.460 \text{ mm} \quad \text{O.K.}$$

Relative Deflection of Transom at Locations 7, 8 and 9

$$= 8.86 - (3.49 + 12.69)/2$$

$$= 0.770 \text{ mm} < \text{Span} / 250 = 1365.0 / 250 = 5.460 \text{ mm}$$

$$= \text{span} / 1773 = 5.460 \text{ mm} \quad \text{O.K.}$$

Observation for negative pressure up to -2.50 kPa

(For Locations of transducers, please refer to Figure 1)

Pressure in kPa	Displacement in mm								
	Locations of Transducers								
	Mullion			Mullion			Transom		
	Span = 2560 mm			Span = 1365 mm			Span = 1365 mm		
	1	2	3	4	5	6	7	8	9
Mode 2									
At Pressure = -2.50	6.44	14.12	5.10	8.04	13.10	14.95	3.93	9.66	13.93
At Pressure = 0.00	2.23	2.01	0.97	1.40	1.96	2.42	0.59	1.53	2.09
Relative Disp. (mm)	--	0.410	--	--	0.050	--	--	0.190	--
At Pressure = -0.50	2.77	4.54	2.43	3.24	4.51	5.01	1.10	2.96	4.47
At Pressure = -1.00	3.53	6.79	3.17	4.41	6.59	7.39	1.70	4.45	6.68
At Pressure = -1.50	4.55	9.17	3.81	5.57	8.70	9.90	2.35	6.10	9.05
At Pressure = -2.00	5.50	11.56	4.43	6.77	10.85	12.38	3.06	7.82	11.42
At Pressure = -2.50	6.46	14.08	5.08	8.01	13.12	15.01	3.94	9.65	13.91
Relative Disp. (mm)	--	8.310	--	--	1.610	--	--	0.725	--
Permitted Relative Displ. #	--	10.240	--	--	5.460	--	--	5.460	--
At Pressure = 0.00	2.44	2.25	1.13	1.60	2.25	2.77	0.66	1.70	2.33
Relative Disp. (mm)	--	0.465	--	--	0.065	--	--	0.205	--
At Pressure = -2.50	6.40	14.03	5.03	7.98	13.09	14.98	3.86	9.57	13.85
Relative Disp. (mm)	--	8.315	--	--	1.610	--	--	0.715	--
Permitted Relative Displ. #	--	10.240	--	--	5.460	--	--	5.460	--
At Pressure = -2.00	6.03	12.17	4.66	7.16	11.47	13.11	3.31	8.29	12.04
At Pressure = -1.50	5.54	10.13	4.19	6.19	9.63	11.05	2.67	6.91	10.04
At Pressure = -1.00	4.91	8.04	3.67	5.14	7.74	8.91	2.05	5.50	7.98
At Pressure = -0.50	3.84	5.43	2.88	3.84	5.45	6.26	1.40	3.75	5.43
At Pressure = 0.00	2.58	2.35	1.21	1.71	2.43	2.92	0.68	1.81	2.45
Relative Disp. (mm)	--	0.455	--	--	0.115	--	--	0.245	--
Mode 3									
At Pressure = 2.50	4.29	13.13	6.27	8.01	12.51	13.85	3.48	8.71	12.57
Relative Disp. (mm)	--	7.850	--	--	1.580	--	--	0.685	--
At Pressure = 0.00	0.07	0.23	0.14	0.21	0.36	0.43	0.07	0.18	0.23
Relative Disp. (mm)	--	0.125	--	--	0.040	--	--	0.030	--

note -The Deflection of Framing Member should not exceed span/250

Detailed Calculation for Relative Deflections at Design Wind Load (-2.50 kPa)

Relative Deflection of Mullion at Locations 1, 2 and 3

$$\begin{aligned}
 &= 14.03 - (6.40 + 5.03)/2 \\
 &= 8.315 \text{ mm} < \text{Span} / 250 = 2560.0 / 250 = 10.240 \text{ mm} \\
 &= \text{span} / 308 = 10.240 \text{ mm} \quad \text{O.K.}
 \end{aligned}$$

Relative Deflection of Mullion at Locations 4, 5 and 6

$$\begin{aligned}
 &= 13.12 - (8.01 + 15.01)/2 \\
 &= 1.610 \text{ mm} < \text{Span} / 250 = 1365.0 / 250 = 5.460 \text{ mm} \\
 &= \text{span} / 848 = 5.460 \text{ mm} \quad \text{O.K.}
 \end{aligned}$$

Relative Deflection of Transom at Locations 7, 8 and 9

$$\begin{aligned}
 &= 9.65 - (3.94 + 13.91)/2 \\
 &= 0.725 \text{ mm} < \text{Span} / 250 = 1365.0 / 250 = 5.460 \text{ mm} \\
 &= \text{span} / 1883 = 5.460 \text{ mm} \quad \text{O.K.}
 \end{aligned}$$

Observation for positive pressure up to 2.50 kPa

(For Locations of transducers, please refer to Figure 1)

Pressure in kPa	Glass Panel			
	Span = 1325 mm			
	10	11	12	
Take-up				
At Pressure = 2.50	14.95	19.31	4.97	
At Pressure = 0.00	0.48	0.41	0.18	
<i>Zero reference</i>	0.00	0.00	0.00	Z1
Mode 1				
At Pressure = 0.50	2.96	4.11	0.94	
At Pressure = 1.00	6.49	8.53	1.98	
At Pressure = 1.50	9.46	12.42	2.97	
At Pressure = 2.00	12.11	15.90	3.95	
At Pressure = 2.50	14.57	19.08	4.87	
Relative Disp. (mm)	--	9.360	--	
Permitted Relative Displ. #	--	20.000	--	
At Pressure = 0.00	0.06	0.07	0.03	Z2
Relative Disp. (mm)	--	0.025	--	
At Pressure = 2.50	14.56	19.09	4.83	
Relative Disp. (mm)	--	9.395	--	
Permitted Relative Displ. #	--	20.000	--	
At Pressure = 2.00	12.53	16.32	4.14	
At Pressure = 1.50	10.18	13.06	3.30	
At Pressure = 1.00	7.77	9.56	2.36	
At Pressure = 0.50	4.37	5.12	1.25	
At Pressure = 0.00	0.06	0.08	0.02	Z3
Relative Disp. (mm)	--	0.040	--	

note -The Deflection of glass panel should not exceed span/60 and 20mm

Detailed Calculation for Relative Deflections at Design Wind Load (2.50 kPa)

Relative Deflection of Glass Panel at Locations 10, 11 and 12

$$= 19.09 - (14.56 + 4.83)/2$$

$$= 9.395 \text{ mm} < \text{Span} / 60 = 1325.0 / 60 = 22.083 \text{ mm}$$

$$= \text{span} / 141 = 20.000 \text{ mm}$$

O.K.

Observation for negative pressure up to -2.50 kPa

(For Locations of transducers, please refer to Figure 1)

Pressure in kPa	Displacement in mm		
	Locations of Transducers		
	Glass Panel		
	Span = 1325 mm		
	10	11	12
Mode 2			
At Pressure = -2.50	15.22	19.71	6.60
At Pressure = 0.00	1.69	1.12	0.52
Relative Disp. (mm)	--	0.015	--
At Pressure = -0.50	4.62	5.26	1.52
At Pressure = -1.00	7.19	9.07	2.63
At Pressure = -1.50	9.83	12.74	3.78
At Pressure = -2.00	12.45	16.24	5.07
At Pressure = -2.50	15.19	19.69	6.59
Relative Disp. (mm)	--	8.800	--
Permitted Relative Displ. #	--	20.000	--
At Pressure = 0.00	1.94	1.31	0.65
Relative Disp. (mm)	--	0.015	--
At Pressure = -2.50	15.11	19.57	6.47
Relative Disp. (mm)	--	8.780	--
Permitted Relative Displ. #	--	20.000	--
At Pressure = -2.00	13.03	16.73	5.52
At Pressure = -1.50	10.72	13.42	4.29
At Pressure = -1.00	8.40	10.02	3.17
At Pressure = -0.50	5.48	5.82	1.85
At Pressure = 0.00	2.03	1.33	0.59
Relative Disp. (mm)	--	0.020	--
Mode 3			
At Pressure = 2.50	14.45	19.26	4.79
Relative Disp. (mm)	--	9.640	--
At Pressure = 0.00	0.24	0.12	0.16
Relative Disp. (mm)	--	-0.080	--

note -The Deflection of glass panel should not exceed span/60 and 20mm

Detailed Calculation for Relative Deflections at Design Wind Load (-2.50 kPa)

Relative Deflection of Glass Panel at Locations 10, 11 and 12

$$= 19.69 - (15.19 + 6.59)/2$$

$$= 8.800 \text{ mm} < \text{Span} / 60 = 1325.0 / 60 = 22.083 \text{ mm}$$

$$= \text{span} / 151 = 20.000 \text{ mm}$$

O.K.

6.3 Operating Force Test (AS/NZS 4420.1-2016 Clause 4)

Procedure

The testing procedures described in section 5.3 were followed.

Observation

Product and movement type		Test Force(N)			
		1	2	3	Mean
Awning Sash	Open	54.6	52.6	52.0	53.06 < 160

6.4 Air Infiltration Test (AS/NZS 4284:2008 Clause 8.4)

Procedure

The testing procedures described in section 5.4 were followed.

Observation of Window Wall System 150A

Specimen area = $3.02 \times 2.70 = 8.154 \text{ m}^2$

The airflow rates measured during the test were as follows:

Test Pressure (Pa)	+150	+300	-150	-300
Air Flow Rate (m ³ /hr)	18.04	20.52	17.31	20.25

Allowable Flow Rate for **Specimen** at +150Pa

$$\begin{aligned}
 &= 8.154 \text{ m}^2 \times 1.6 \text{ L/sec/m}^2 \\
 &= 13.046 \text{ L/sec} \\
 &= 46.96 \text{ m}^3/\text{hr} > 18.04 \text{ m}^3/\text{hr} \quad \text{O.K.}
 \end{aligned}$$

Allowable Flow Rate for **Specimen** at -150Pa

$$\begin{aligned}
 &= 8.154 \text{ m}^2 \times 1.6 \text{ L/sec/m}^2 \\
 &= 13.046 \text{ L/sec} \\
 &= 46.96 \text{ m}^3/\text{hr} > 17.51 \text{ m}^3/\text{hr} \quad \text{O.K.}
 \end{aligned}$$

The rate of air leakage of the specimen was within allowable values.
(AS/NZS 4284:2008 Table D1)

Allowable Flow Rate for **Specimen** at +300Pa

$$\begin{aligned}
 &= 8.154 \text{ m}^2 \times 1.0 \text{ L/sec/m}^2 \\
 &= 8.154 \text{ L/sec} \\
 &= 29.35 \text{ m}^3/\text{hr} > 20.52 \text{ m}^3/\text{hr} \quad \text{O.K.}
 \end{aligned}$$

Allowable Flow Rate for **Specimen** at -300Pa

$$\begin{aligned}
 &= 8.154 \text{ m}^2 \times 1.0 \text{ L/sec/m}^2 \\
 &= 8.154 \text{ L/sec} \\
 &= 29.35 \text{ m}^3/\text{hr} > 20.25 \text{ m}^3/\text{hr} \quad \text{O.K.}
 \end{aligned}$$

The rate of air leakage of the specimen was within allowable values.
(For information)

6.5 Water Penetration Test - Static (AS/NZS 4284:2008 Clause 8.5)
Procedure

The testing procedures described in section 5.5 were followed.

Observation

No water leakage was observed.

6.6 Water Penetration Test - Cyclic (AS/NZS 4284:2008 Clause 8.6)
Procedure

The testing procedures described in section 5.6 were followed.

Observation

No water leakage was observed.

6.7 Structural Test at Ultimate Limit State (AS/NZS 4284:2008 Clause 8.8)
Procedure

The testing procedures described in section 5.7 were followed.

Observation

No collapse was observed under the specified pressure.

The maximum pressures attained were +4.7 kPa/ -4.7 kPa.

7. Summary of Test Results

Test	Results
1.1.1) Preliminary Test- Static Pressure Test (AS/NZS 4284:2008 Clause 8.2.2)	No separation, plastic deformations or deleterious was observed. Please refer to Clause 6.1.1 for details.
1.1.2) Preliminary Test- Water Penetration Test - Static (AS/NZS 4284:2008 Clause 8.2.3)	No water leakage was observed. Please refer to Clause 6.1.2 for details.
1.1.3) Preliminary Test- Water Penetration Test - Cyclic (AS/NZS 4284:2008 Clause 8.2.3)	No water leakage was observed. Please refer to Clause 6.1.3 for details.
2) Structural Test at Serviceability Limit State (AS/NZS 4284:2008 Clause 8.3)	During the structural test at Serviceability Limit State, the deflections of the framing members as well as glass panel were within the allowable deflection limits. Maximum successive member displacement did not exceed 3 mm. (SLS pressure =+/-2.5 kPa) Please refer to Clause 6.2 for details.
3) Operating Force Test (AS/NZS 4420.1-2016 Clause 4)	The test force was within allowable value. Please refer to Clause 6.3 for details.
4) Air Infiltration Test (AS/NZS 4284:2008 Clause 8.4)	The rate of air leakage of the specimen at +/-150Pa was less than 1.6 L/sec/m ² . The rate of air leakage of the specimen at +/-300Pa was less than 1.0 L/sec/m ² . Please refer to Clause 6.4 for details.
5) Water Penetration Test - Static (AS/NZS 4284:2008 Clause 8.5)	No water leakage was observed. Please refer to Clause 6.5 for details.
6) Water Penetration Test - Cyclic (AS/NZS 4284:2008 Clause 8.6)	No water leakage was observed. Please refer to Clause 6.6 for details.
7) Structural Test at Ultimate Limit State (AS/NZS 4284:2008 Clause 8.8)	No collapse was observed under the specified pressure. (ULS pressure =+/-4.7 kPa) Please refer to Clause 6.7 for details.

I certify the above test results are the true record for the performance test of the **KETE Window Wall System 150D** designed by **Guangdong Kete Facadetech Co., Ltd.**

For and on the behalf of
 Research Engineering Development
 Façade Consultants Limited




Dr. ZHANG Zhuoran
 Authorized Signature

Appendices

Figure 1 - Location of displacement transducers

Photo 1 - Photograph of the PMU Test Mock-up

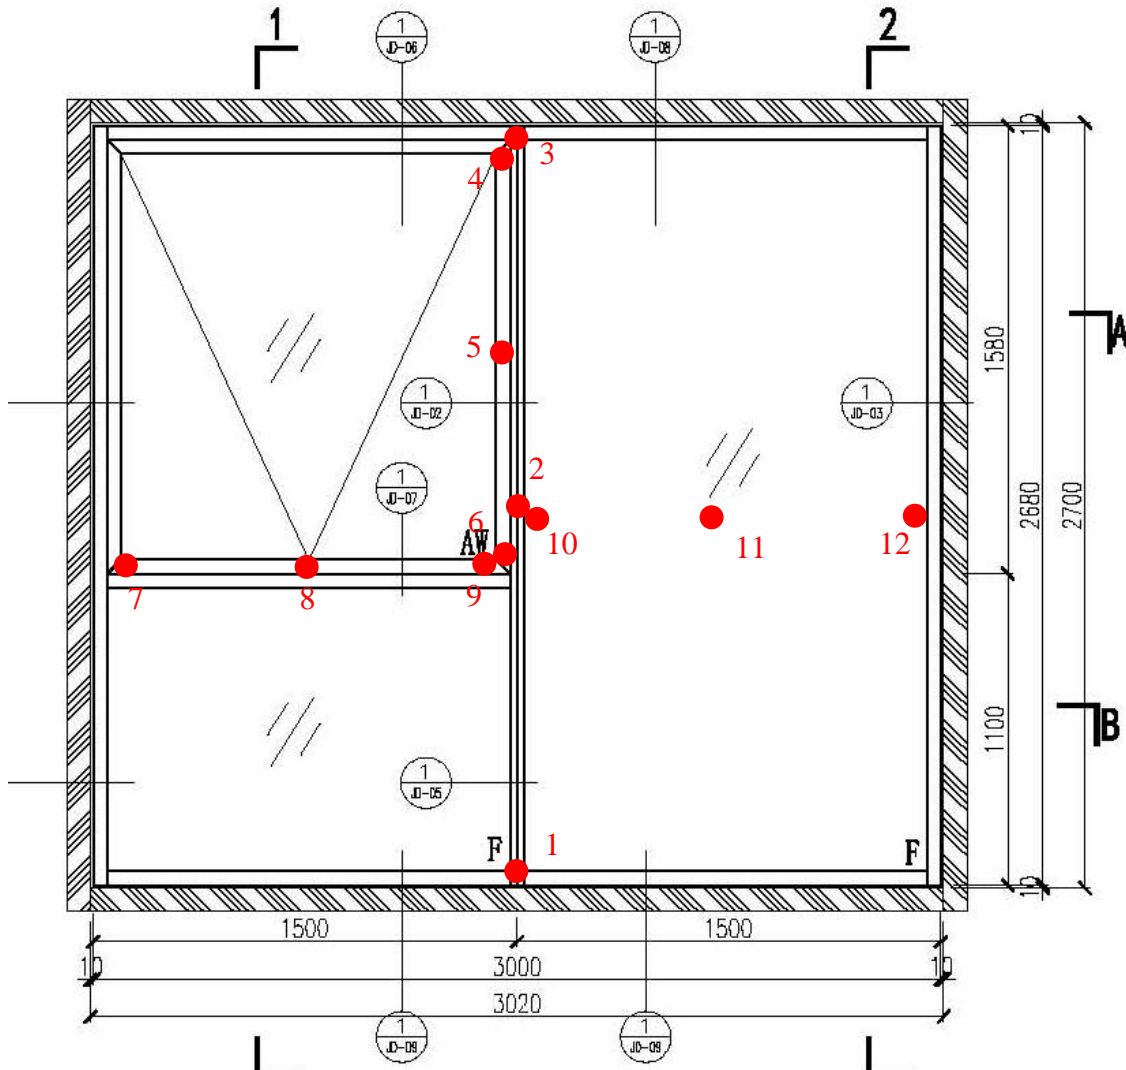

Mullion: 1-2-3, 4-5-6
Transom: 7-8-9
Glass Panel: 10-11-12


Figure 1: Locations of Displacement Transducers (Outside View)



Photo 1: Mock-up of the Window Wall System 150D


- End of Report -


As-built PMU Test drawings from client

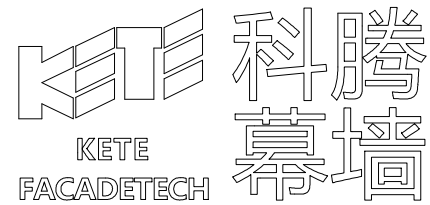

KETE WINDOW WALL 150D SYSTEM

2019.01.10

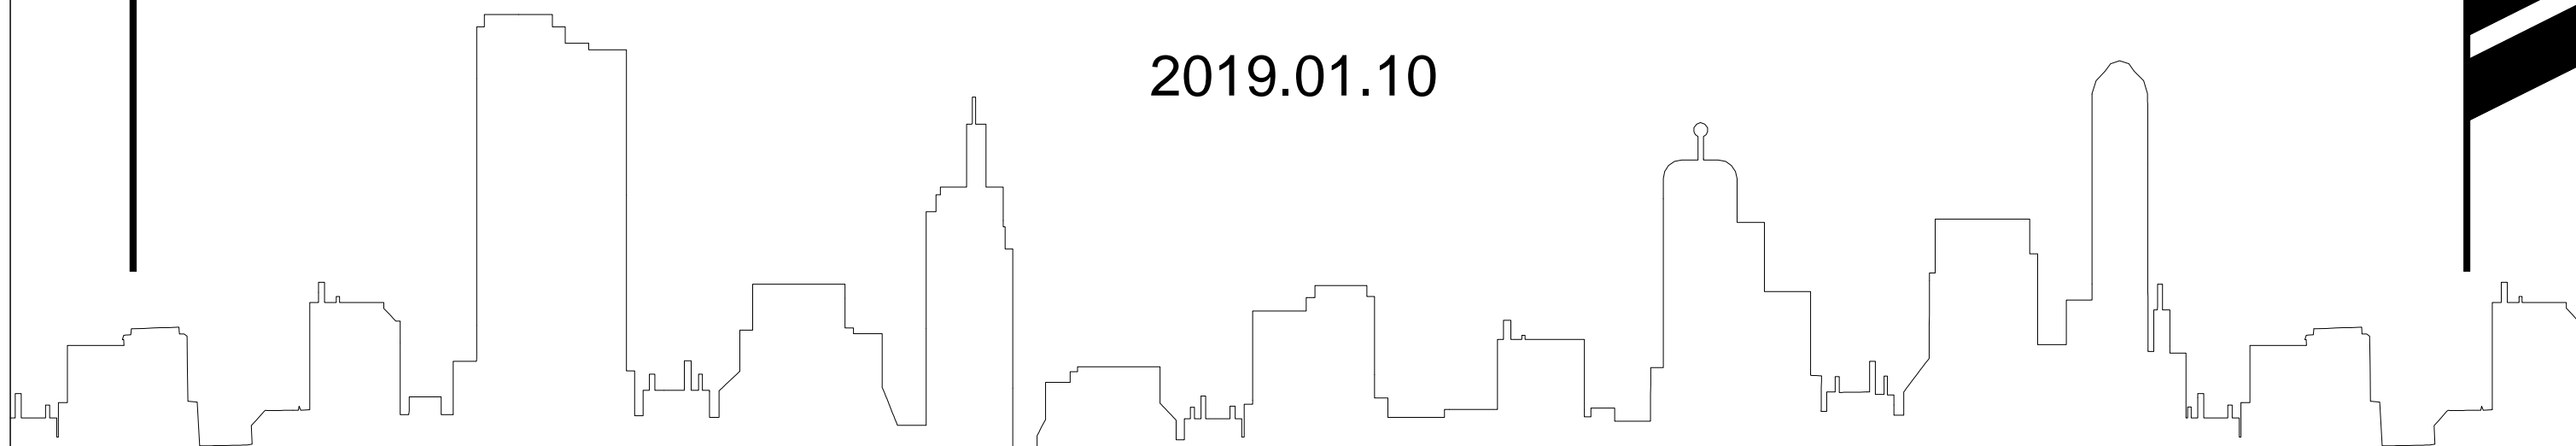

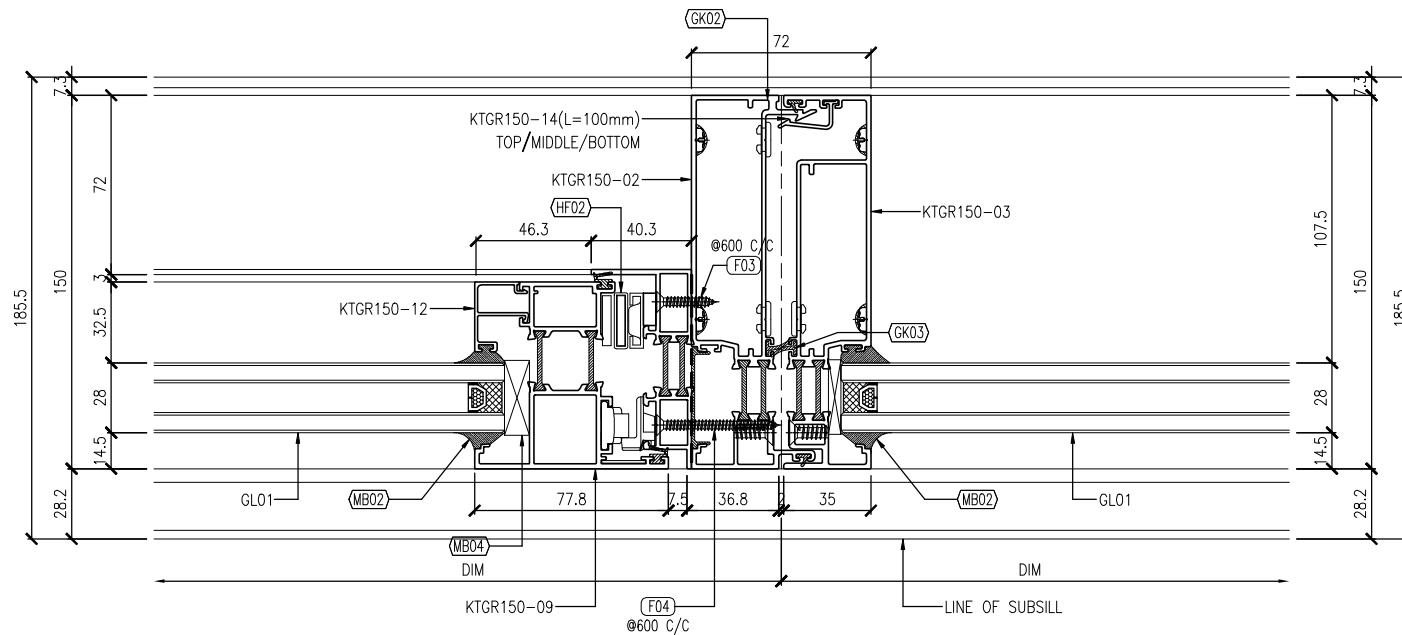

设计变更

日期	变更内容

备注:
Notes

1. 图上所有尺寸以标注为准, 勿以度量。
2. 图上所有尺寸单位均为mm, 除非另有标注。
3. 图上所有加 * 尺寸表示特定尺寸。

建筑设计
Architect

业主
Owner

工程监理
Supervisor

总承包
Contractor



TEL: +86-757-81800209 FAX: +86-757-81800199
 MAIL: Design@kete.cn MAIL: Marketing@kete.cn
 Http://www.gkete.cn

工程名称 KETE WINDOW WALL
 Project Name 150D SYSTEM

工程编号
 Project No.

图名 DETAIL-150D
 Drawing Name

设计 ZI JIAN
 Design

审核 KIM
 Check

批准 JOHN
 Approve

日期 2019. 01. 10
 Scale

图纸编号 JD-02
 Drawing No.

修改序号 R 0
 Revision No.

